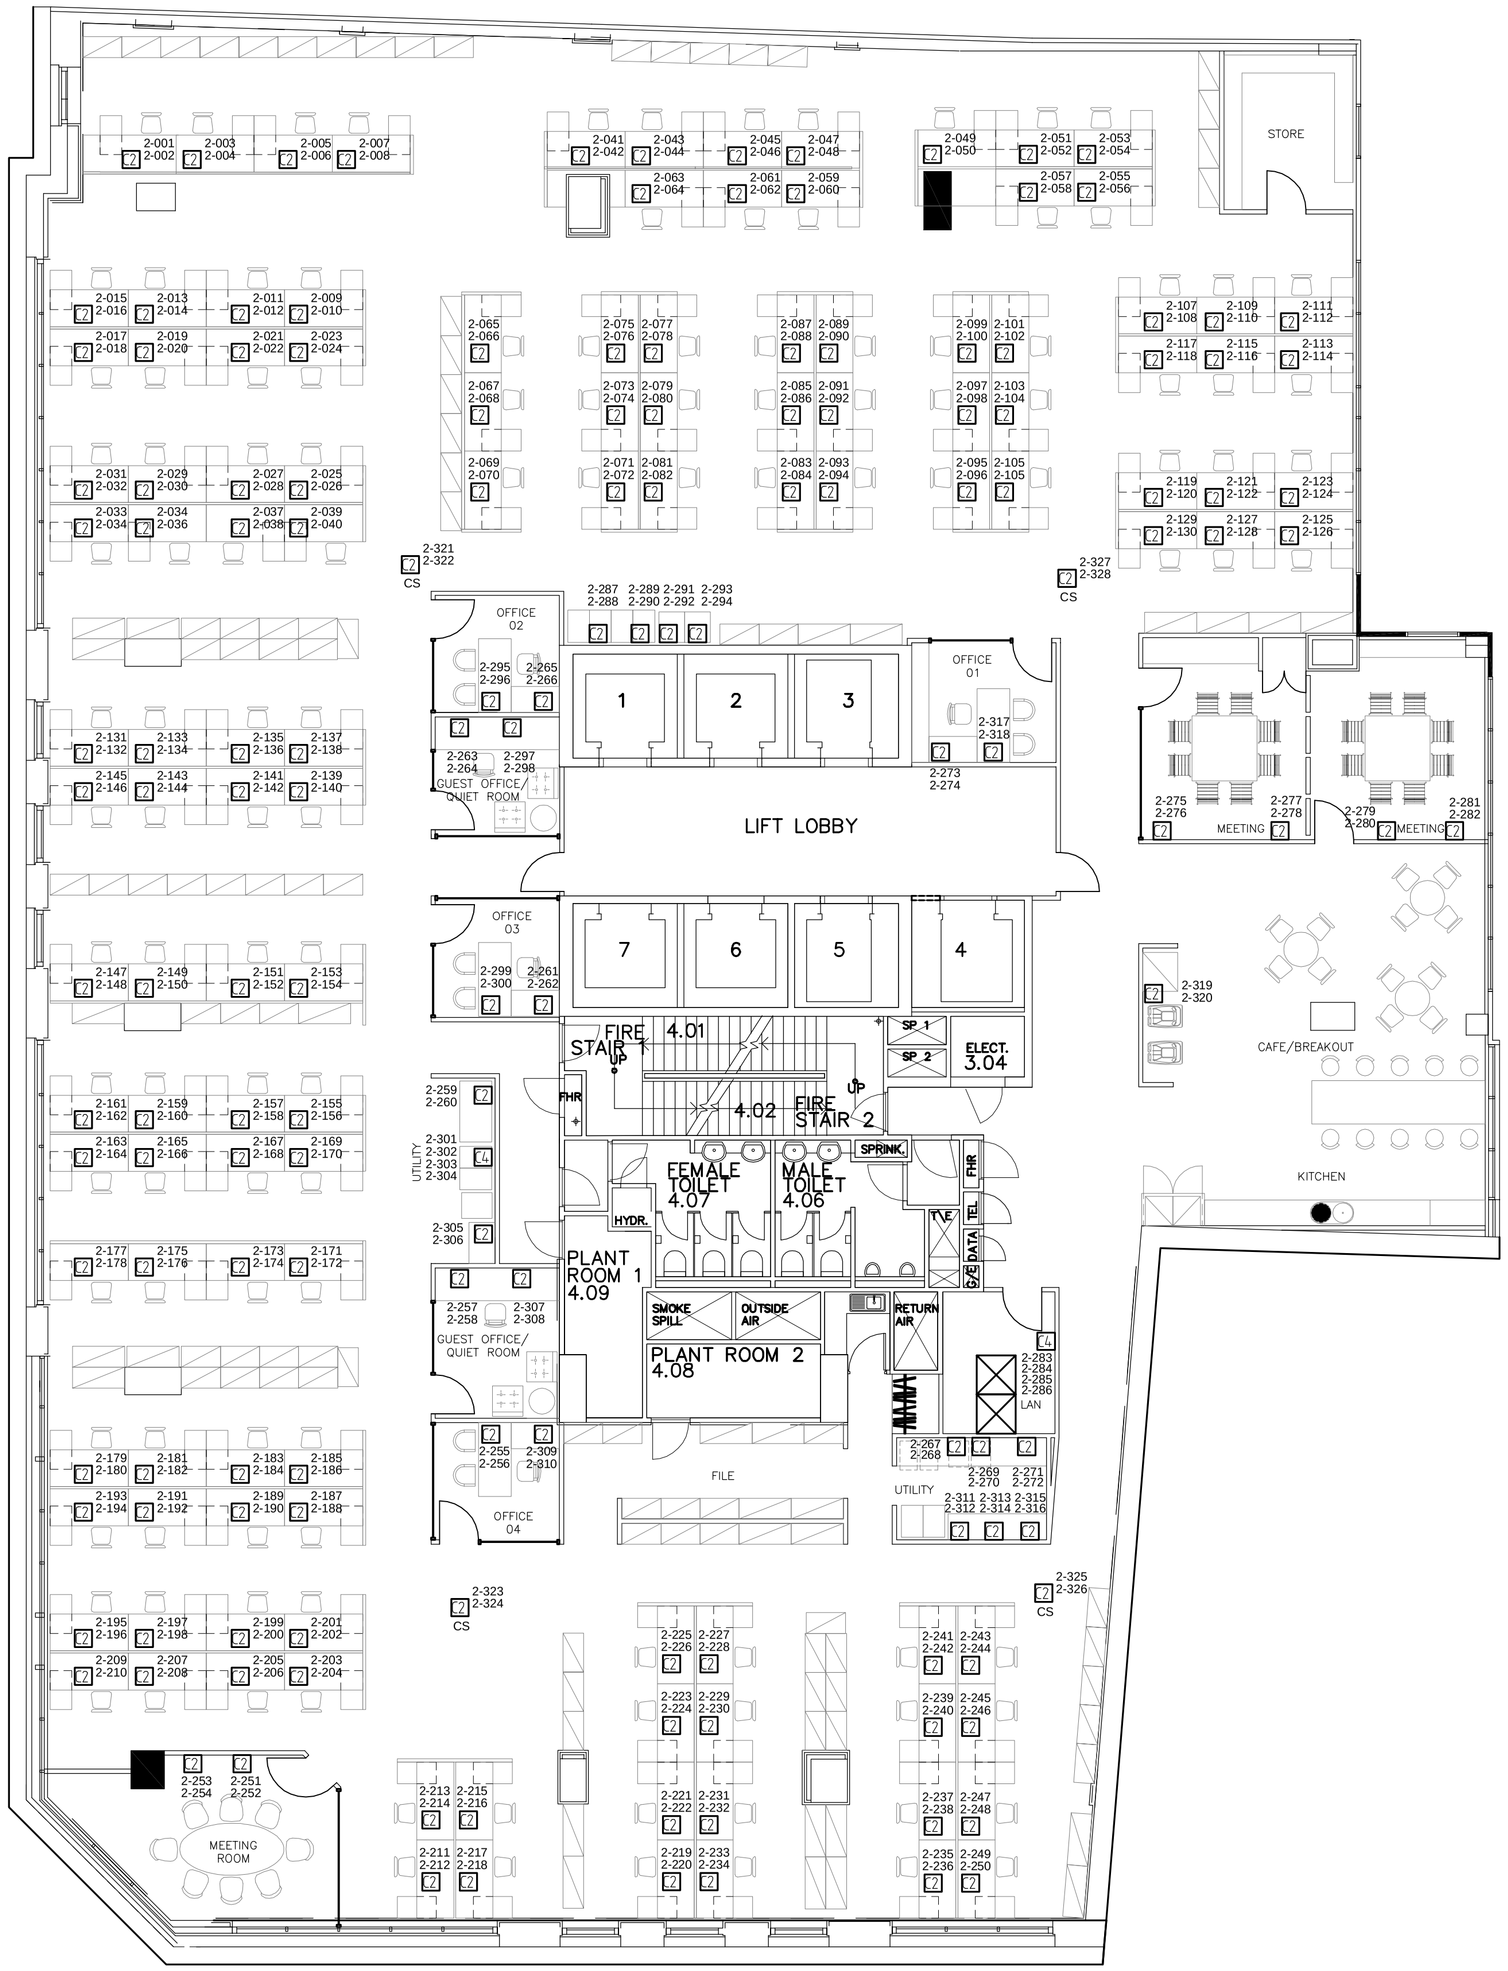

AMENDMENTS

REV	DESCRIPTION	BY	DATE
AB	AS BUILT	LB	

LEGEND

COMMUNICATIONS OUTLET
CS DENOTES POINTS IN CEILING SPACE

ELECTRICAL CONTRACTOR

CLIENT

PROJECT/ ADDRESS

DRAWING TITLE

ELECTRICAL SERVICES

COMMS LAYOUT

SCALE 0 2 4 8

BAR SCALE 1:100_ON_A1_PAPER

Drawings by
A.B.N. 24 091 542 844
M & O Drafting Pty. Ltd.
4/7 MATSON CRESCENT
YOWIE BAY NSW 2228
Tel: 9540 4105
Tel: 9540 5268
Mob: 0416 119 867

DRAWN	DATE DRAWN	CHECK	APPROVED	CLIENT
LB		MB	GC	

JOB NUMBER	DRAWING NUMBER	REVISION
		AB

A1