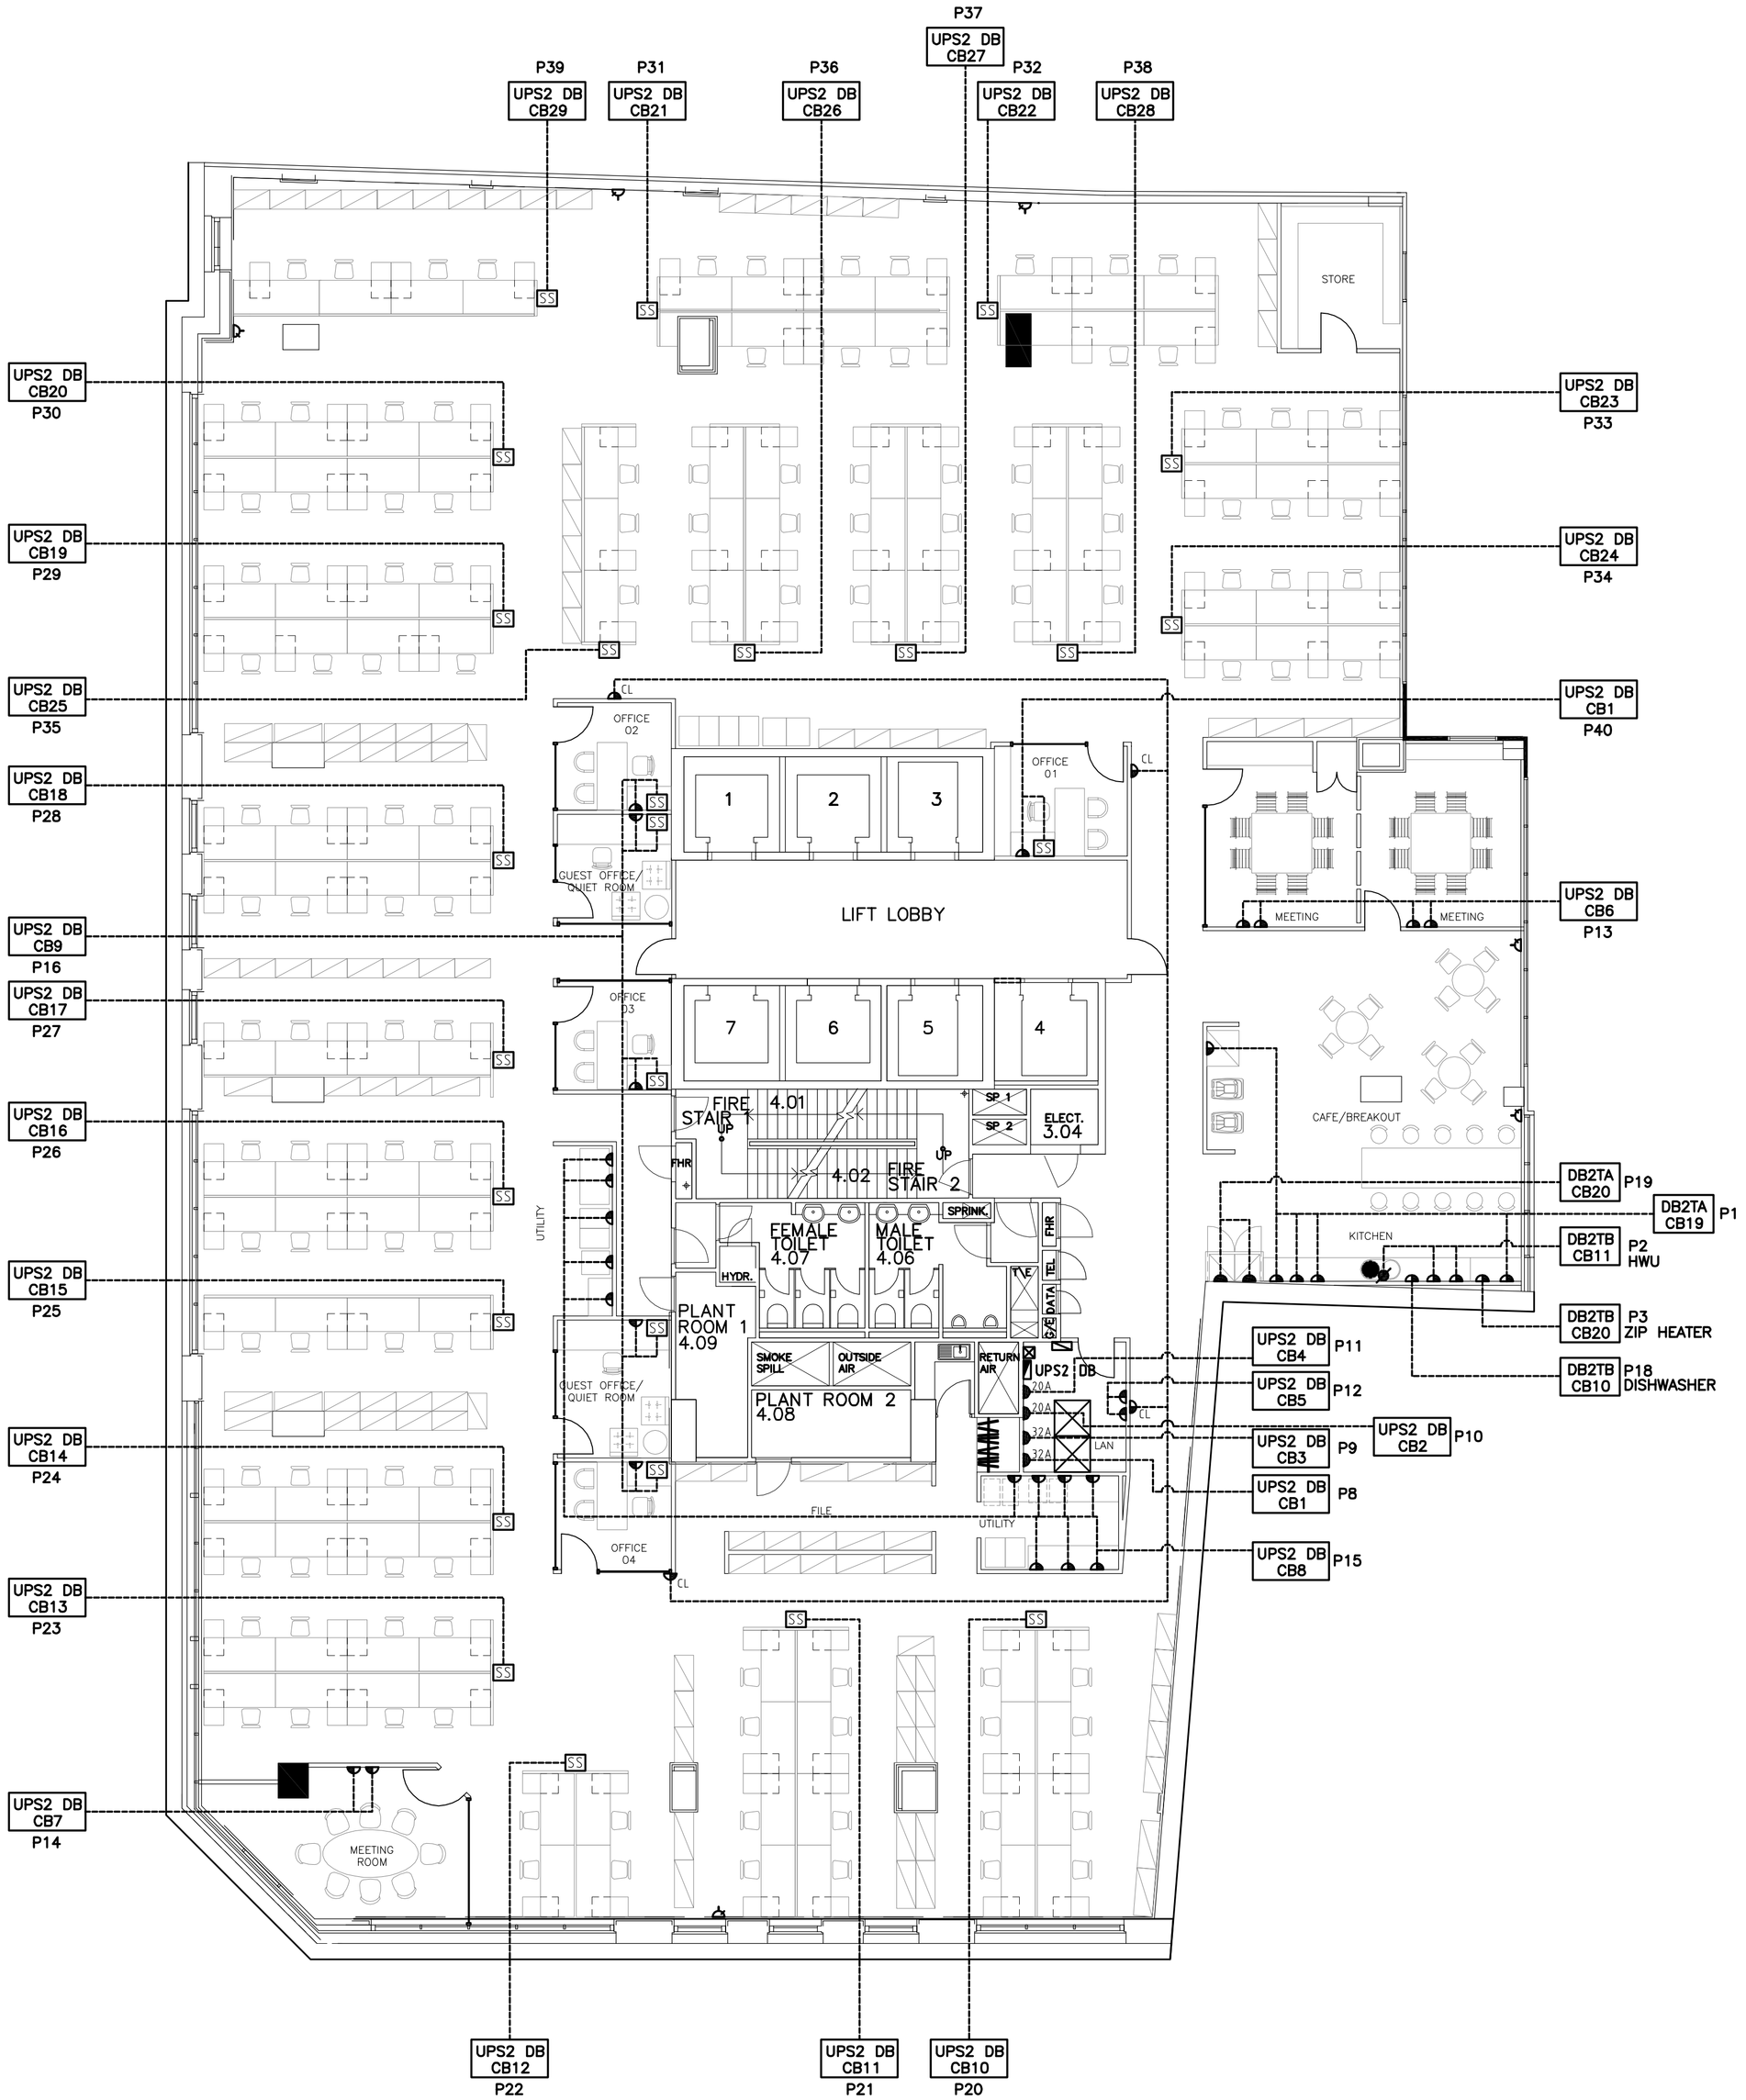

AMENDMENTS

REV	DESCRIPTION	BY	DATE
AB	AS BUILT	LB	

LEGEND

- SS — STARTER SOCKET
- PERMANENTLY CONNECTED OUTLET 3PH DENOTES THREE PHASE IS DENOTES COMPLETE WITH ISOLATOR
- SINGLE 10 Amp GENERAL PURPOSE OUTLET
- CL — SINGLE 10 Amp CLEANERS OUTLET ON RCD PROTECTED CIRCUIT
- DOUBLE 10 Amp GENERAL PURPOSE OUTLET (WORKSTATION OUTLETS PROVIDED BY WORKSTATION TRADE)
- 32A — 32 Amp IP56 1Ø OUTLET
- 20A — 20 Amp IP56 1Ø OUTLET
- DOUBLE 10 Amp GENERAL PURPOSE OUTLET SKIRTING KITS

ELECTRICAL CONTRACTOR

CLIENT

PROJECT/ ADDRESS

DRAWING TITLE

ELECTRICAL SERVICES

POWER LAYOUT

SCALE 0 2 4 8

BAR SCALE 1:100_ON_A1_PAPER

Drawings by
M & O Drafting Pty. Ltd.
A.B.N. 24 091 542 844
4/7 MATSON CRESCENT
YOWIE BAY NSW 2228
Tel: 9540 4105
Tel: 9540 5268
Mob: 0416 119 867

DRAWN	DATE DRAWN	CHECK	APPROVED	CLIENT
LB		MB	GC	

JOB NUMBER	DRAWING NUMBER	REVISION
		AB

A1